

\$10.00 fee
for permit

ISLAND COUNTY HEALTH DEPARTMENT
Post Office Box 218 - Coupeville, Washington

Phone 678-4008

281-71

APPLICATION FOR PERMIT TO CONSTRUCT A SEWAGE DISPOSAL SYSTEM

Applicant's name: JOHN ZEILSTRA

Mailing address: 9140 900 AV. WEST O.H. Phone: 675-5182

Location of construction site: WESTRIDGE DEV. #1

RIDGEWAY DR. 1/4 MILE
Street number Distance to nearest cross road

Legal description: Lot #7 Sec. Twp. Blk. Rge. Addition WESTRIDGE Div #1

Type of use RESIDENTIAL No. of bedrooms 3 No. of bathrooms 1 1/2

Lot width: 67 ft. Lot depth: 120 ft. 8040 sq. ft.

Source of drinking water: Public supply X Private Well

1. Dig a hole at least 4 feet deep in the disposal field area. After the hole is dug record the soil conditions at the following depths:
(record as sand, gravel, clay, packed sand, loam, etc)

12 inches TOPSOIL GRAVEL 24 inches GRAVEL 36 inches GRAVEL 48 inches GRAVEL

2. Furnish sketch on reverse side hereof, or attach plot plan of premises showing -
a. Distances between property lines and sewage system.
b. Distance to any well, spring, creek or other body of water.
c. Show direction and approximate slope of lot.
d. Show the location and layout of the septic tank system.
e. List size of septic tank, inside length, inside width, water depth capacity in gallons.
f. Width, length and depth of drain lines, amount of gravel under tile, amount of gravel over tile, type of tile used.
g. Location of buildings and driveways, swimming pools, etc.

3. Percolation test made 3 Date 25 Result: 3.5 MIN PER INCH

I hereby state that the information above and on the reverse side hereof, or attached hereto is correct and true to the best of my knowledge. I understand that the permit must be obtained before any construction is begun, either on the building or the sewage disposal system, and a satisfactory inspection of system is required before the sewage disposal system may be backfilled, or put to use.

Signed: John Zeilstra Date: 4/8/71
Owner

Signed: John Zeilstra Date: 4/8/71
Contractor

Plan approved: CHS Permit No. 161-71 Receipt No. 6370 Date 4-9-71

Final inspection approved CHS Rejected By: Date 7-19-71

Remarks:


Permit Expires One Year From Date Issued

281-71

Tank: Gallons Capacity 900 Tank MFG EVERETT BROS CONST

Field Total 110 Width 3' Depth 24" No. of lines 1 Sq Feet 300

Gravel: Size 1/2- Overtile 2" inches, Undertile 6" inches.

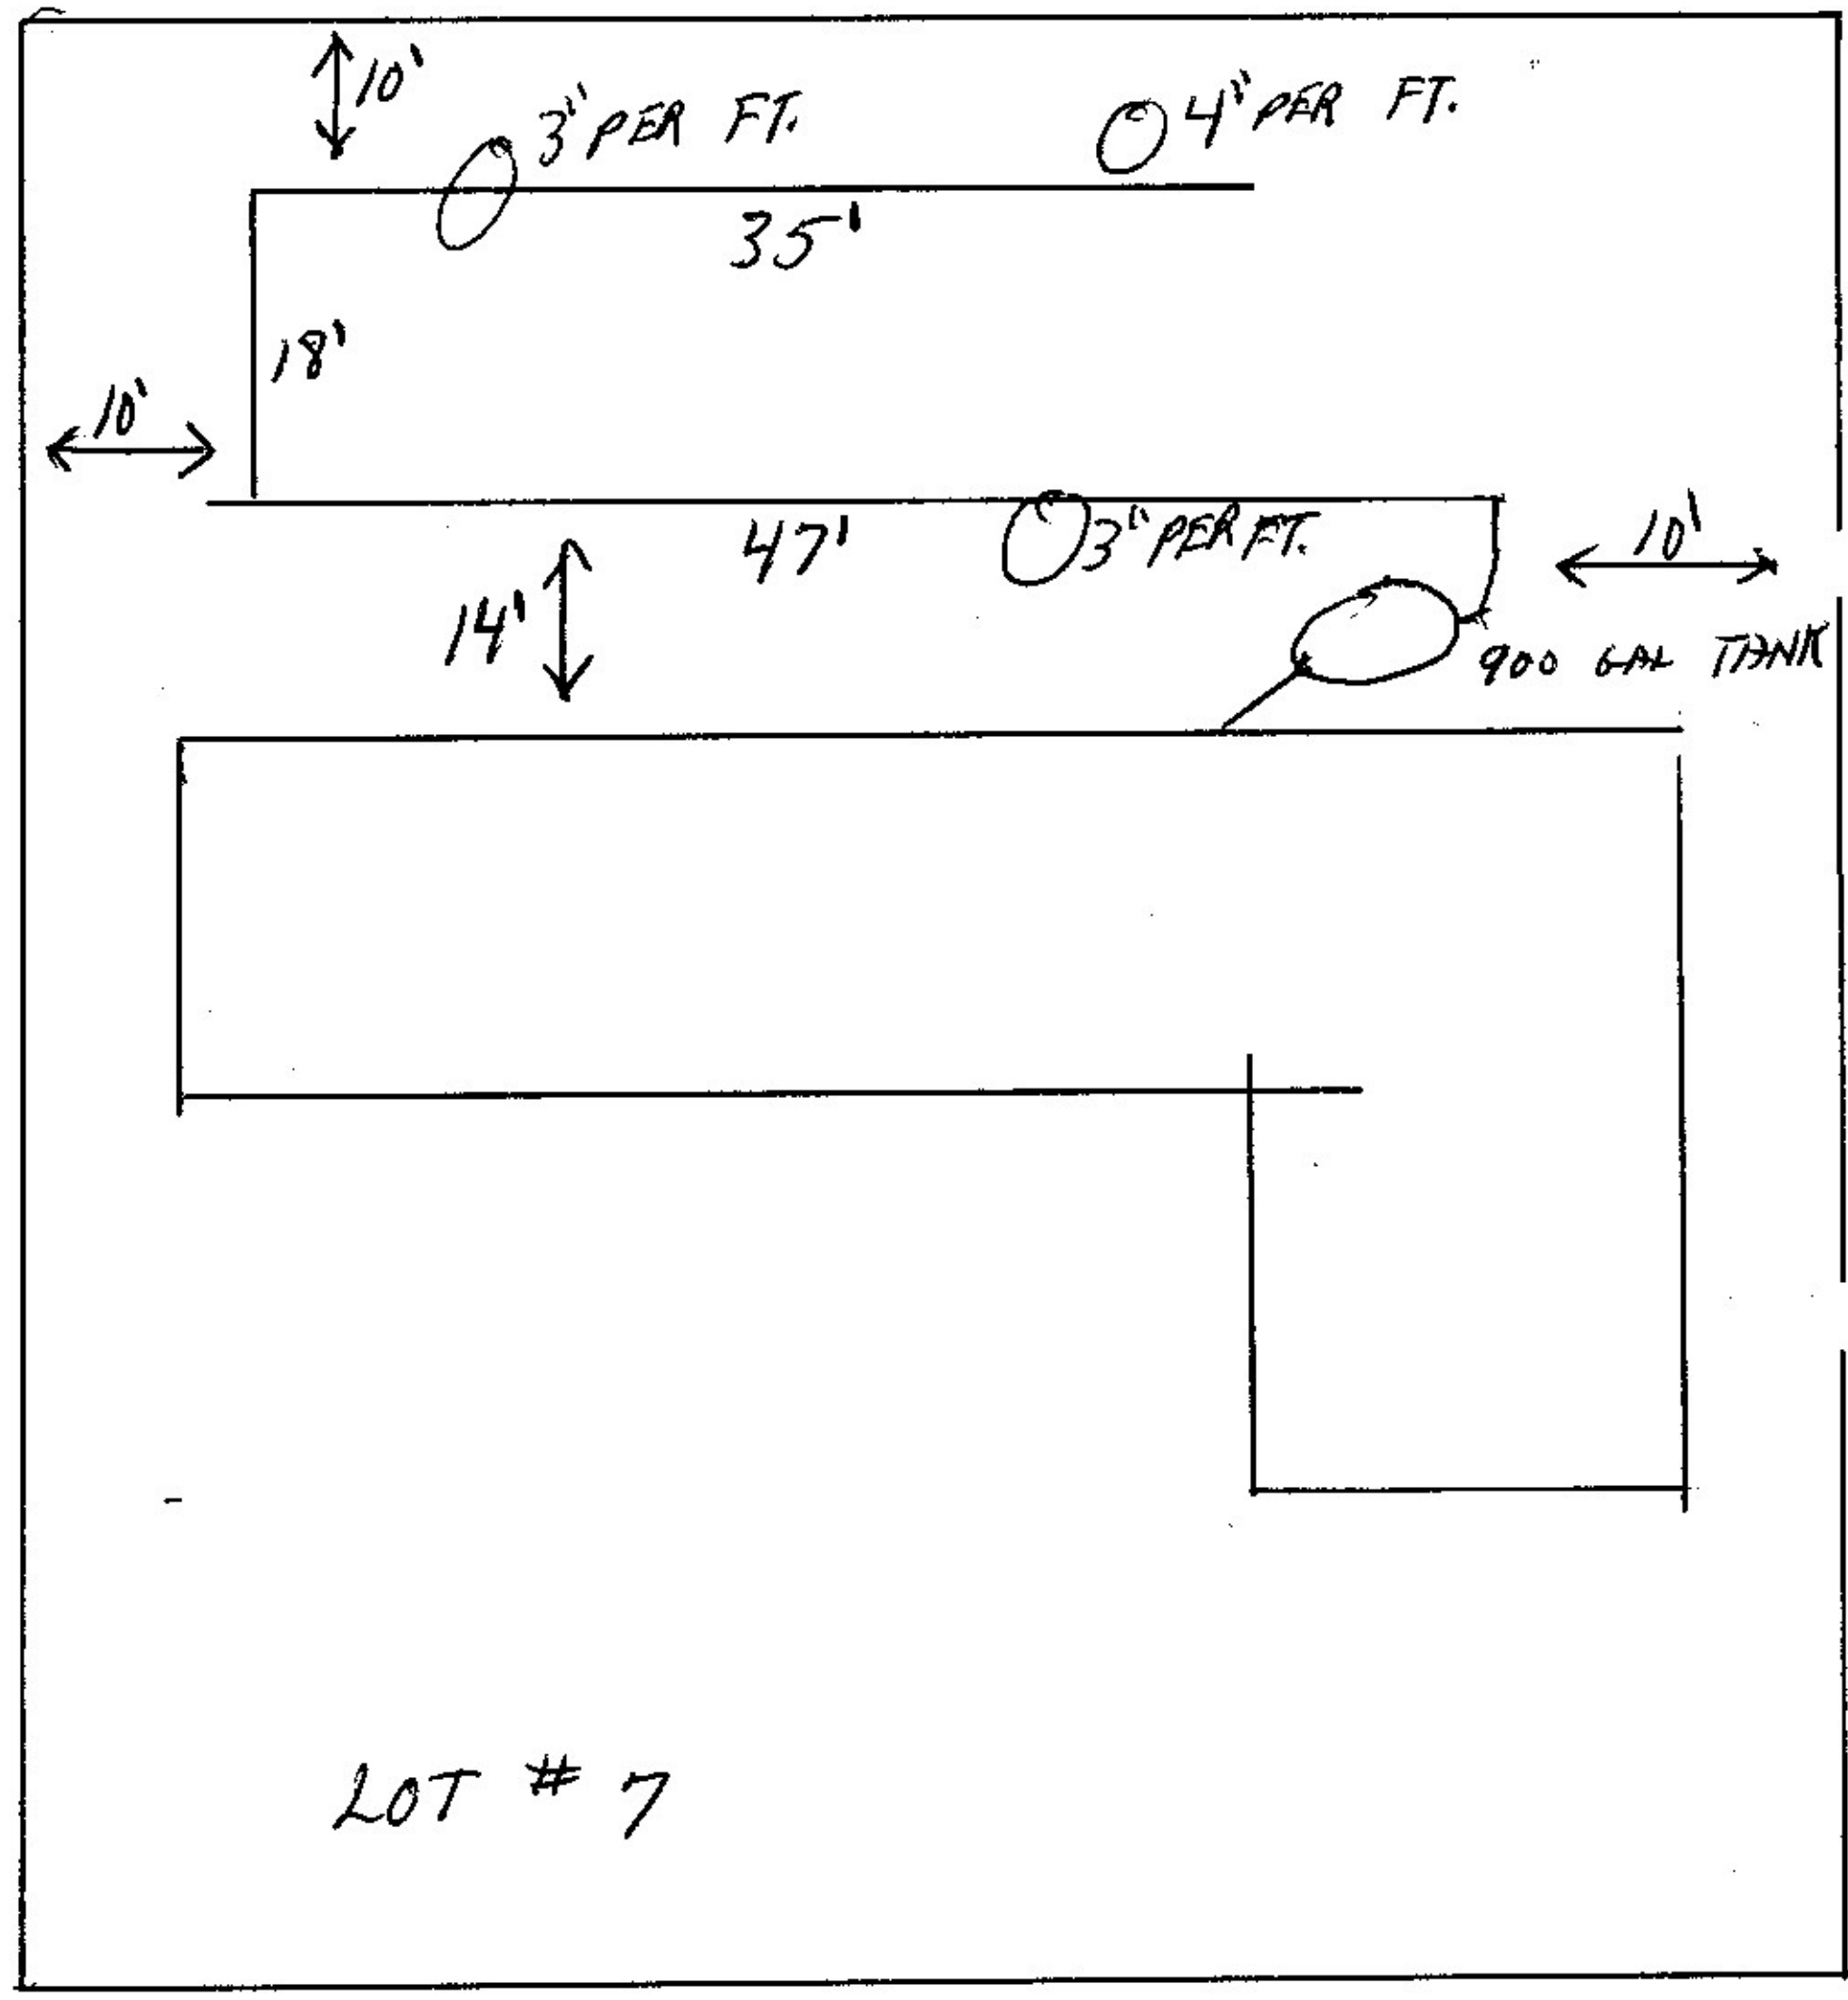

RIDGEWAY DRIVE